



1 EXISTING FLOOR PLAN
A2.0 SCALE: 1/4" = 1'-0"

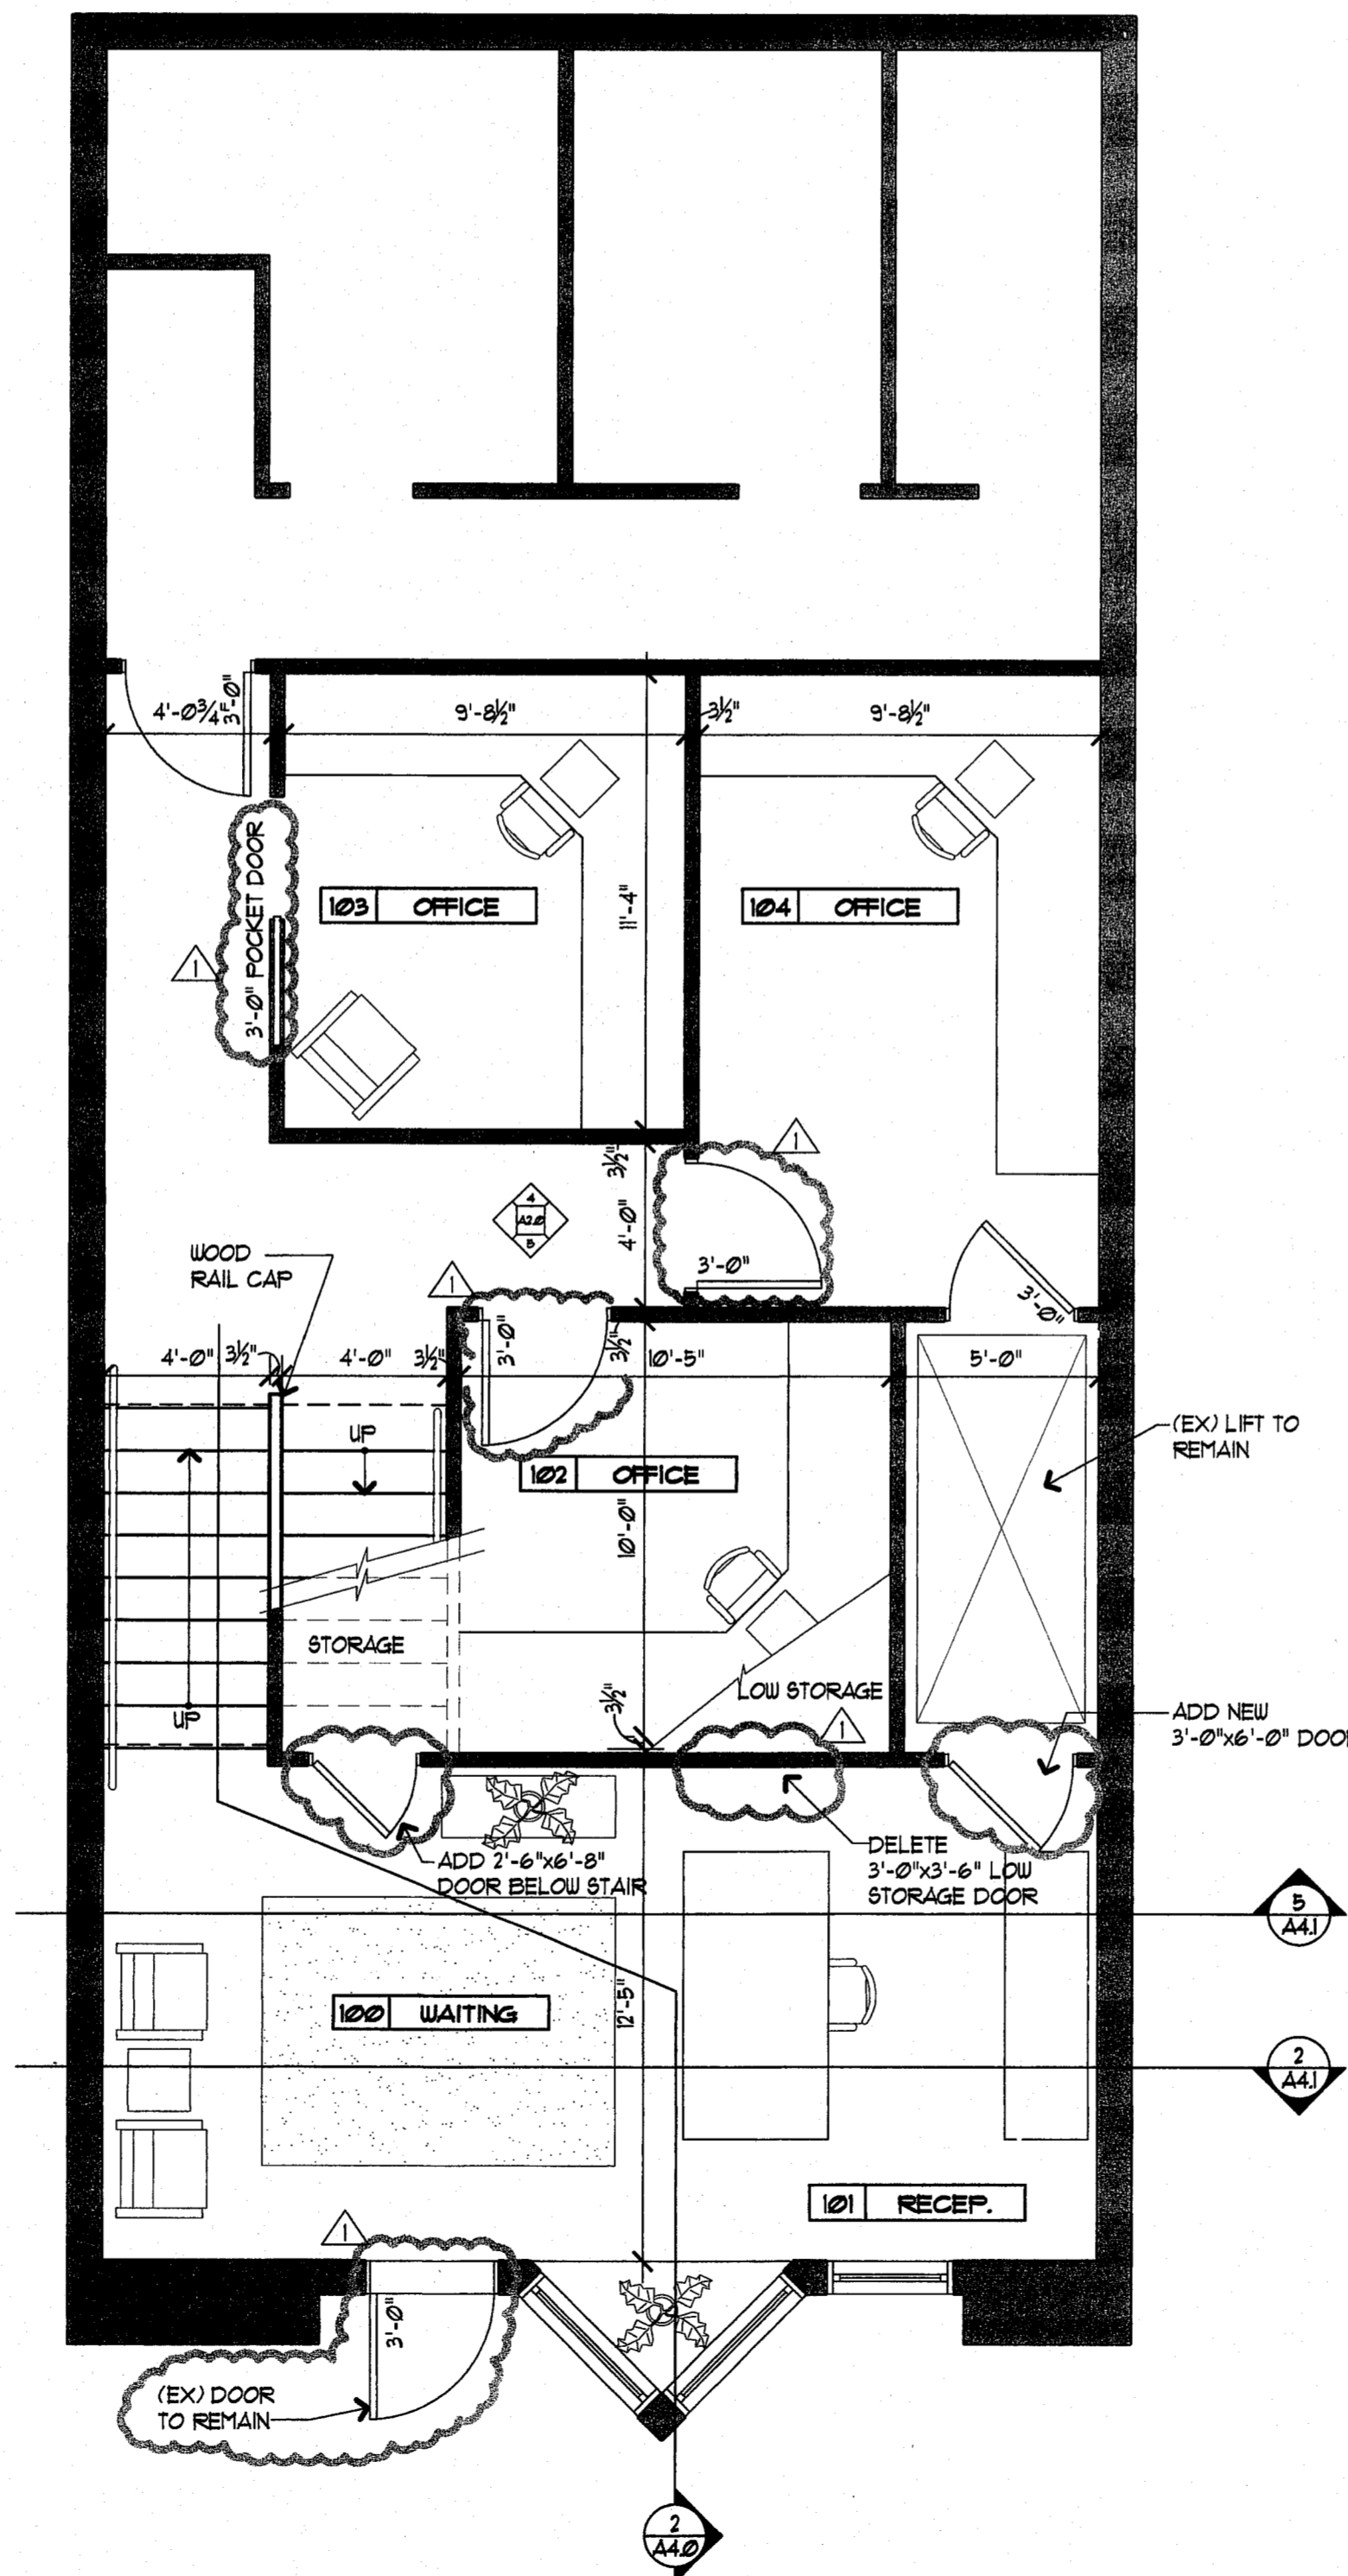


2 NEW LOWER LEVEL FLOOR PLAN
A2.0 SCALE: 1/4" = 1'-0"

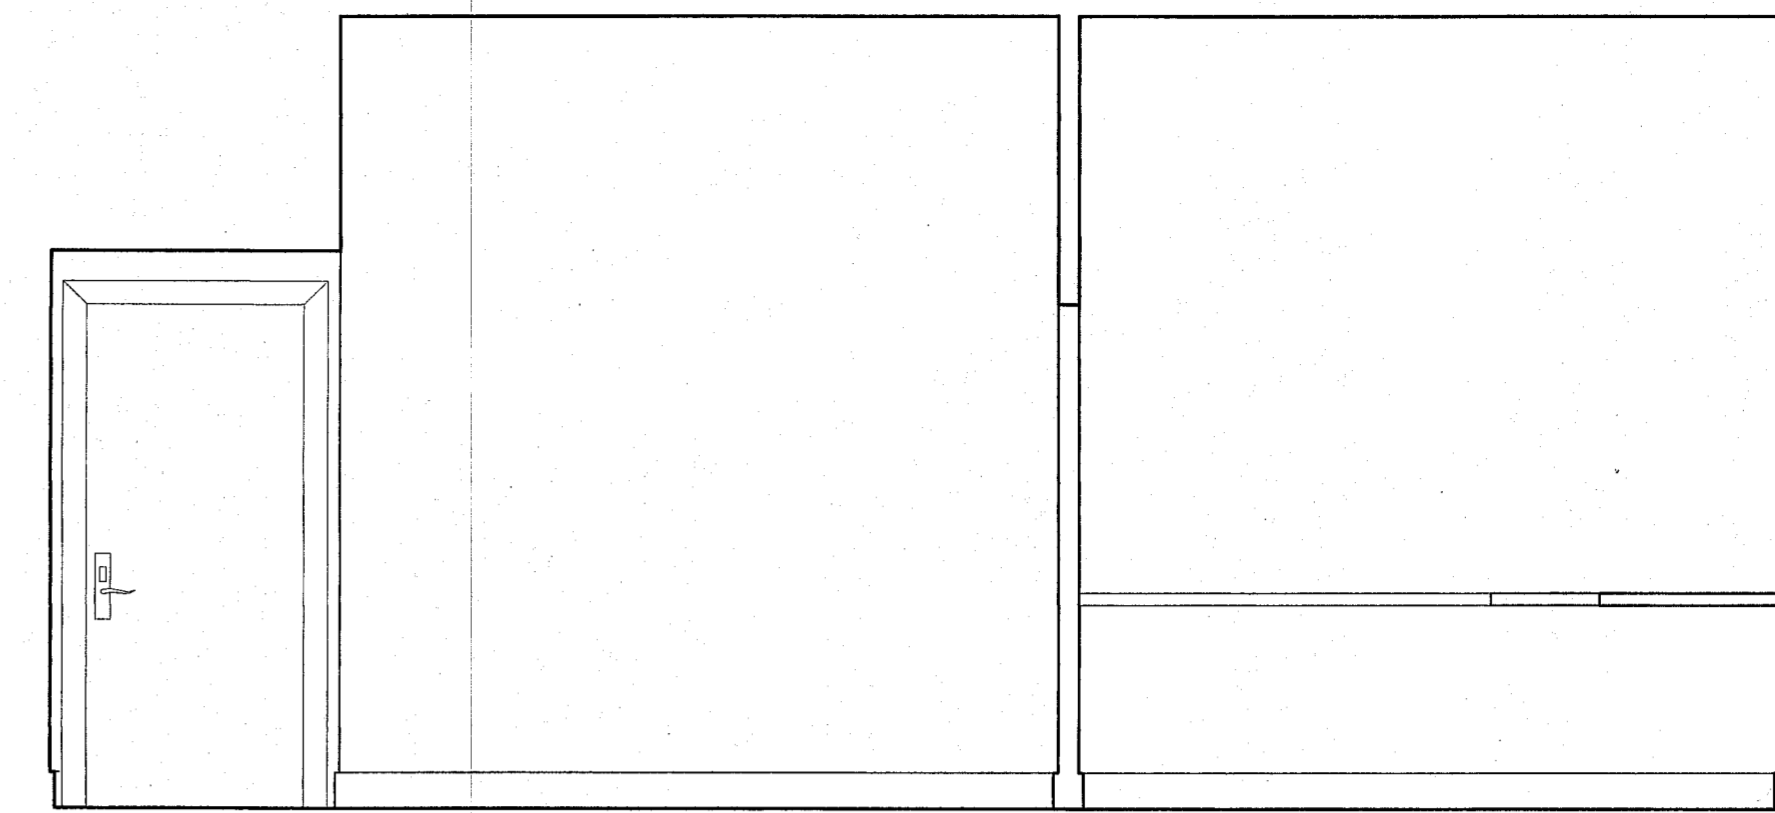


4 HALL ELEVATION
A2.0 SCALE: 3/8" = 1'-0"



5 HALL ELEVATION
A2.0 SCALE: 3/8" = 1'-0"

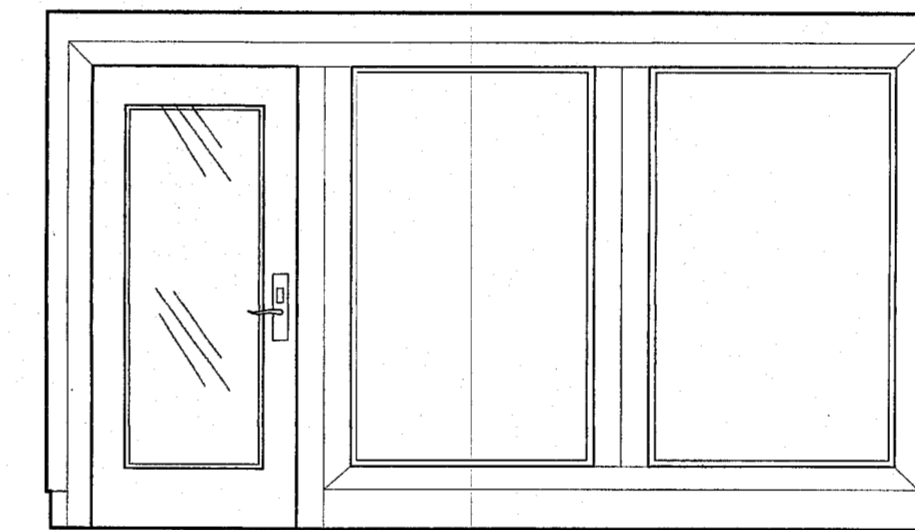

6 CONFERENCE ROOM ELEVATION
A2.0 SCALE: 3/8" = 1'-0"

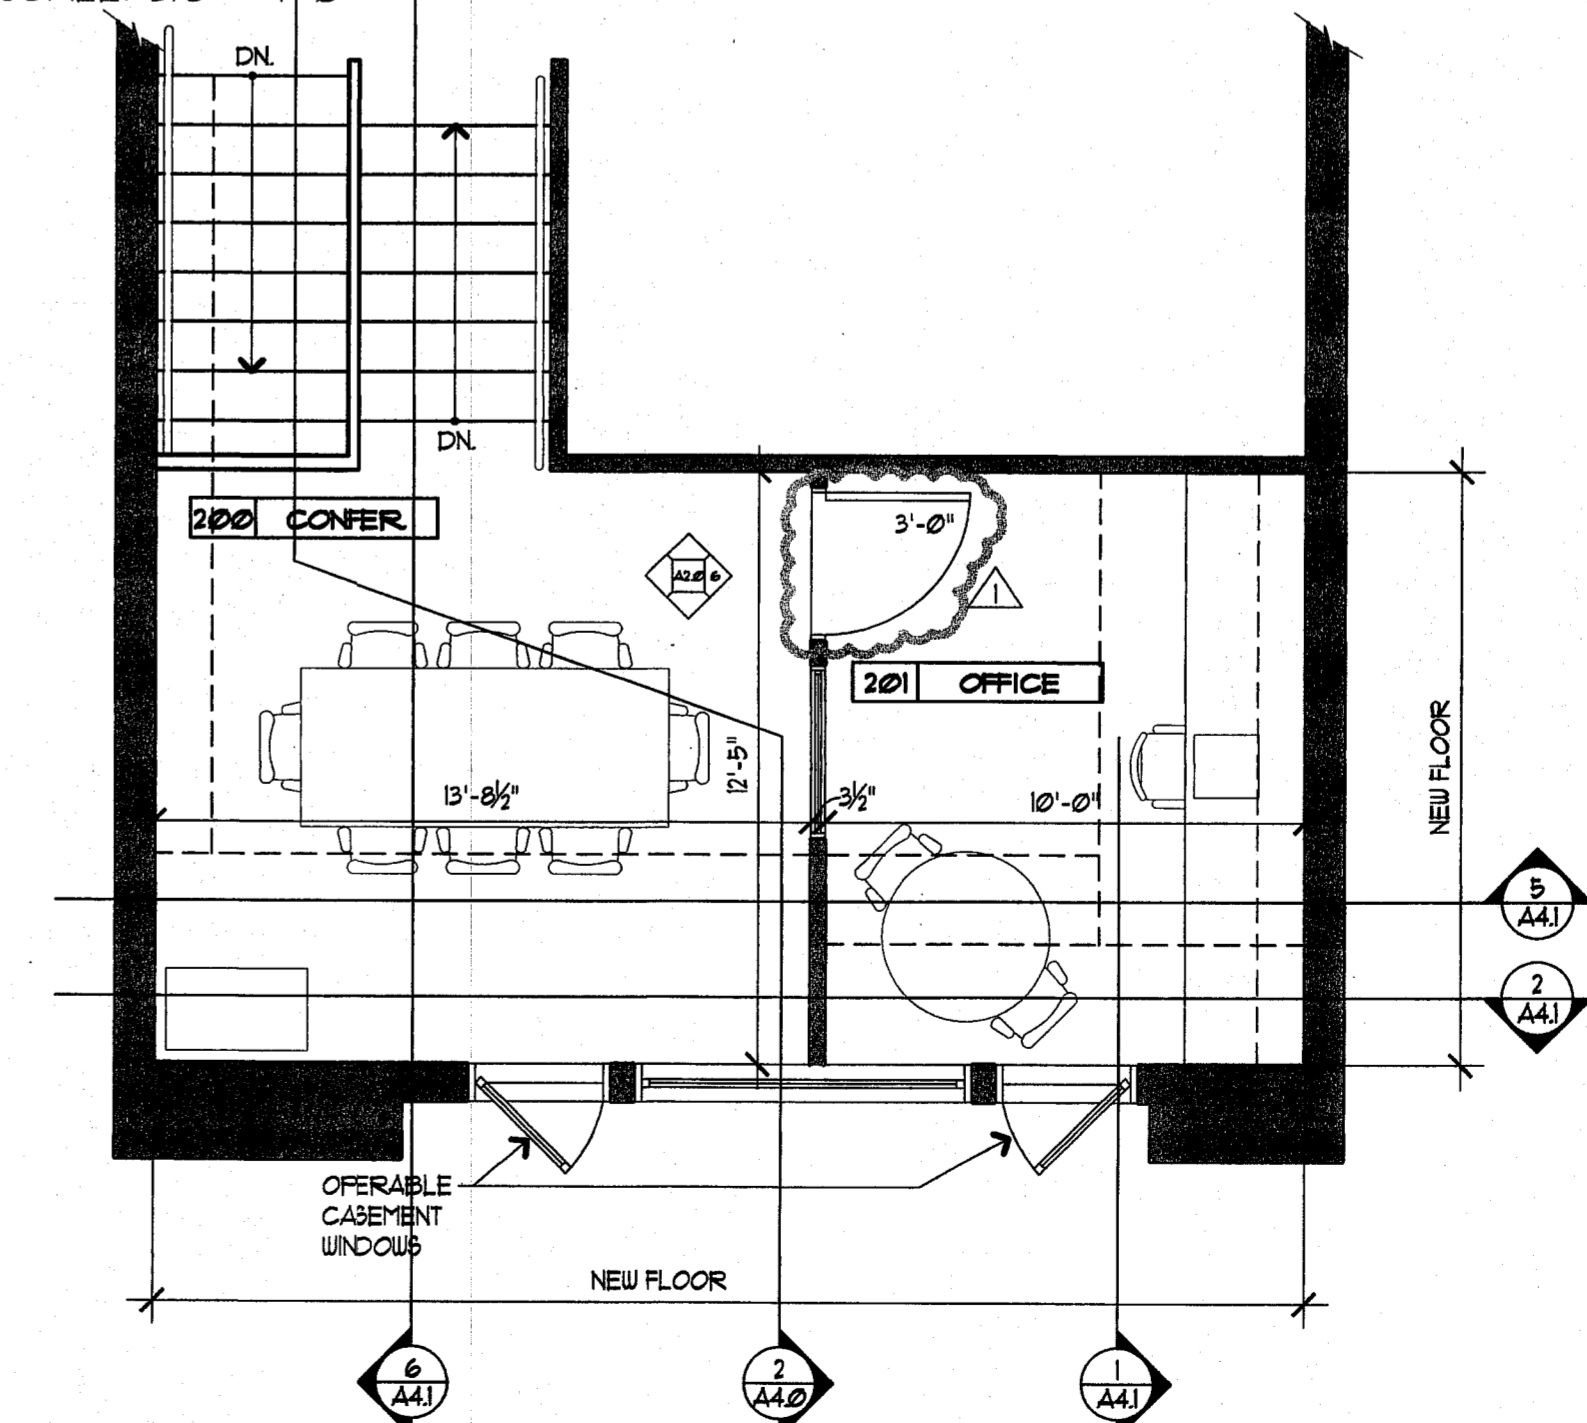

3 NEW UPPER LEVEL FLOOR PLAN
A2.0 SCALE: 1/4" = 1'-0"



Segeberg Mayhew
& Associates Architects
P.C.-A.I.A.

ARCHITECTURE,
PLANNING, INTERIORS

Main Office: Vail, CO
101 Eagle Road, Building 6
Avon, CO 81620
PO Box 4700
Vail, CO 81638
Tel: 970.476.4433
Fax: 970.476.4608
Denver Office
1617 Wazee Street, Suite C2
Denver, CO 80202
Tel: 303.623.3355
Fax: 303.623.2262
info@smarchs.com
www.smarchs.com

EAST WEST DEVELOPMENT OFFICE
BEAVER CREEK, COLORADO

Revisions:

REVISIONS PER PLAN REVIEW	COMMENTS
05-31-05	
05-23-05	

Drawing Title:
FLOOR PLAN

Date: 04/12/05

Project No:

Drawn by: BMC

Checked by: KS

Sheet:

A2.0